ADDENDUM NO. 3

TO: All Bidders and Plan Holders

FROM: Charlie Shell, Principal Engineer

PROJECT: Construction of NE Veterans Drive – Phase II (No. 10444)

DATE: February 1, 2013

This addendum to the contract documents is issued to clarify, correct, and supplement the drawings and contract documents issued as "Construction of NE Veterans Drive – Phase II", bid closing date January 31st, 2013. (REVISED BID OPENING DATE: February 7th, 2013)

Please be advised of the following revisions to the bid documents:

Changes to Supplemental Specifications:

Supplemental Specification #3 – Time of Award, Schedule, and Completion

Delete the existing Supplemental Specification #3, Time of Award, Schedule, and Completion and replace with the following;

3. Time of Award, Project Schedule, and Completion

The anticipated time of award for this project is the February 19th, 2013 Hillsboro City Council meeting held at 7:00 p.m. in the Hillsboro Auditorium, Hillsboro Civic Center, 150 East Main Street, Hillsboro, OR 97123.

The Washington County Fair and the Hillsboro Air Show are both scheduled to occur during the last weekend of July 2013. The contractor shall have the Veterans Drive travel lanes and bike lanes between NE 34th Avenue and Brookwood Parkway paved and open for traffic by July 19th, 2013. All sidewalks between NE 34th Avenue and the proposed driveways at 39+00 shall also be completed by July 19th, 2013. All concrete must be tested and must meet minimum strength requirements prior to opening to traffic.

The contractor will provide a project schedule at the preconstruction meeting outlining the tasks and timelines required to meet this schedule. Should the contractor fall behind schedule, the contractor will be required to use high early strength concrete in order to meet the schedule. The contractor will not receive any additional compensation for the additional costs incurred to bring the project back on schedule. Extensions of schedule will not be allowed due to weather.

After July 19th, the contractor will be required to cease work until the completion of the fair and air show. (An exception may be made if it can be shown that the proposed activities will not interfere with the use of the roadway and sidewalks to provide access to the fair and air show.) The contractor will be responsible for completing any site cleanup necessary to make the area safe to the traveling public.

Upon completion of these events, the newly constructed Veterans Drive will be closed to traffic until the completion of the remaining construction work. All work within this contract shall be complete, tested, and accepted by the City of Hillsboro by October 11th, 2013. If necessary, this final deadline may be extended to November 15, 2013 to allow landscaping to be planted under more favorable weather conditions.

It is the responsibility of the prospective bidders to note the contents of this addendum and that the owner is made aware that the addendum has been received. Acknowledge receipt by noting addendum number and date of receipt on the signature page following the bid proposal form (Section X) and return all addendums with the bid packet on February 7^{th} , 2013 at 2:00 p.m.

Bidder	Name:	
	Address:	
Acknowledg	ged receipt by:	

ADDENDUM NO. 2

TO:

All Bidders and Plan Holders

FROM:

Charlie Shell, Principal Engineer

PROJECT:

Construction of NE Veterans Drive - Phase II

No. 10444

DATE:

January 30, 2013

This addendum to the contract documents is issued to clarify, correct, and supplement the drawings and contract documents issued as "Construction of NE Veterans Drive – Phase II", bid closing date January 31st, 2013.

Please be advised of the following revisions to the bid documents:

Changes to the Bid Closing/Opening Date:

The bid closing/opening date and time have changed from January 31st, 2013 at 2:00 PM to **February 7th**, **2013 at 2:00 PM**. First Tier Subcontractor Disclosure forms must be submitted within two hours of the new bid closing time and date. The anticipated time of City Council award (February 19th, 2013) for this project and the project schedule for completion remain unchanged.

Changes to the Section IX Bid Proposal Form:

These changes apply to the Bid Proposal Form. A new bid proposal form is provided with this addendum. Please replace the entire Bid Proposal Form in the bid book. The following bid quantities have been revised by this addendum.

• 27. Furnish and Install 3-1/2" concrete sidewalks

Changes to the Special Specifications:

Special Specification #6 – Furnish and Install Catch Basins, ditch inlets, and drains.

Add the Following: The unit price bid for sidewalk drains shall include all costs to furnish and install a minimum of five cleanouts.

Special Specification #13 – Excavation.

Add the Following: With the exception of trench spoils, excavation quantities include all excavated material including any to be reused on site for embankment or topsoil.

Special Specification #25 – Raise Existing Structures to Final Grade

Add the Following: Adjustment of existing manhole rims and access hatches will not exceed twelve inches and will be made utilizing grade rings.

It is the responsibility of the prospective bidders to note the contents of this addendum and that the owner is made aware that the addendum has been received. Acknowledge receipt by noting addendum number and date of receipt on the signature page following the bid proposal form (Section X) and return all addendums with the bid packet on February 7^{th} , 2013 at 2:00 p.m.

Bidder	Name:			-
	Address:			-
			 ·	_
Acknowled	ged receipt by:	 		_

SECTION IX BID PROPOSAL FORM

CONSTRUCTION OF NE VETERANS DRIVE (10444) Phase Two

Furnish all equipment, materials and labor required to complete the construction of public streets, storm sewer, and waterline improvements. Proposed street improvements are approximately 2300 linear feet in length and include curb and gutter, raised bike lanes, sidewalks, asphalt and concrete paving, street lighting, signing and striping, traffic signals, landscaping, irrigation, and other associated work.

ITEM#	DESCRIPTION	UNIT	QUANTITY	UNIT PRICE	AMOUNT
1.	Mobilization, Bond, Insurance	LS	1		
2.	Site Preparation , Clearing and Grubbing including brush				
	and tree removal	L.S.	1		
3.	Furnish, Install and Maintain Erosion Control Measures	LS	1		
	T # 0 1 1	LS	1		
4	Traffic Control	LS	l		
	STORM SEWER				
5	Furnish and Install Storm Pipe, full depth rock backfill		4.47		
	a) 10" C-900 Storm Pipe	L.F.	447		
	b) 6" C-900 Storm Pipe	L.F.	300		
6	Furnish and Install Catch Basins, Ditch Inlets, Drains		·		
	a) CG-2	EA.	16		!
	b) CG-30	EA.	2		
	c) Area Drain	EA.	1		
	d) 12" Diameter Landscape Drain	EA.	16		
	e) Sidewalk Drain (SD1 of C100D)	LF	1331		
7	Connect to existing manhole;				
	a) Existing knock-out provided	EA.	9		
	b) Core Drill into manhole	EA	2		

8	Furnish and Install Tees				
	a) Inserta Tee (36" by 10")	EΑ	. 6		
	b) 6" C-900 Tees	EA	14		
9	Remove Inlet in Brookwood and construct 48" Manhole				
	over existing storm line	LS	1		
10	Remove and/or abandon existing storm pipe/structures	LS	1		
	WATERLINE INSTALLATION				
					·
11	Furnish and Install 12" Class 52 Ductile Iron Pipe:	LF	106		
12	Waterline Details				
	a) Detail A - 12" Wet Tap	EA	1	i	
	b) Detail B - 12" MJ Bend	EA	5		
	c) Detail C - 4" Blowoff Assembly	EA	11		
	d) Detail D - Relocate Existing Waterline	EA	1		
	ROADWAY CONSTRUCTION				
		5			
13	Excavation - includes removal of all spoils	CY	14,342		
	A MARKET				
14	Embankment - cement amended fills	CY	2050		
15	Sub grade Preparation / Cement Amendment	SY	14,000		
		1			
16	Furnish and Install 6" of 1-1/2" minus Base Rock	:		-	
	in street sections and under Bike Lane	cu. yd.	2,160		
17	Furnish and Install 2" of 3/4" minus Leveling Rock	-			
	in street sections and under Bike Lane	cu. yd.	720		
18	Furnish and Install Mountable Curb and Gutter per				
	detail C2-100B	LF	4,377		
			ļ		

19	Furnish and Install Modified City Curb and Gutter per				-
	detail C1-100B	LF	4,158		
20	Furnish and Install Mod. Washington County Standard				
	Curb and Gutter (Center median Brookwood Pkwy.)				
	per detail C3-106	LF	61		
					· .
21	Furnish and Install Washington County Standard				
	Curb and Gutter (Brookwood Parkway) per				
	detail C4-106	LF	328		
22	Furnish and Install Asphalt (Brookwood Parkway)				
	a) Level 3, 3/4" Dense Graded	ton	185		
	b) Level 3, 1/2" Dense Graded	ton	46		
			i		
23	Furnish and Install 11" thick PCC Pavement	SY	8,245		
				,	3
24	Furnish and Install Impact Slabs	SF	510		
25	Raise Existing Structures to Final Grade				
	a) Manhole Rims	each	22		
	b) Contech Water Quality 3' by 9' Access Hatches	each	2		
26	Furnish and Install 6" thick concrete cycle track.				
	(bike lanes)	SY	3,242		
····					
27	Furnish and Install 3-1/2" Conc. Sidewalks				
	(includes 3/4" minus base rock)	SF	39,848		
			,		
28	Furnish and Install 6" thick Conc. Driveways with				
	mesh reinforcement (includes 3/4" minus base rock)	SF	3,081		
	The state of the s		-,		
29	Furnish and Install Handicap Ramps	EA	6		
	Lation and motern ractionap racings				
30	Furnish and Install Truncated Domes	SF	166		
30	T GINGH GIM HIGGIN TIGHOUTOU DOINGS			1	

	MISCELANEOUS	***************************************				
31	Foundation Stabilization measured					
	in place (price includes excavation)	cu. yd.	400		• !	
	4.00					-
32	Saw Cut existing asphalt	L.F.	2,000			
www.						
	STREET LIGHTING					
33	Furnish and Install Street Lighting System Complete	LS	1			
					 	
	TRAFFIC SIGNALS, SIGNING AND STRIPING	NG				
34	Furnish and Install Traffic Signals at Brookwood Parkway	LS	1			
35	Furnish and Install Traffic Signs complete with perforated					
	post breakaway sign supports or steel band connections	į				
	as indicated on the plans.					
	(a) - No Parking Bike Lane	each	16			
	(b) - Speed 35	each	2			
	(c) - Speed Reduction	each	2	1		
	(d) - Keep Right	each	3			
	(e) - Ahead	each	1			
	(f) - Pedestrian	each	11		* •	
	(g) - Roundabout	each	1		A STATE OF THE STA	
	(h) - Bikes Entering Roadway	each	1			
	(i) - Bike Lane Ends	each	1			
	(j) - Brookwood Pkwy Next Signal	each	1	<u> </u>	<i></i>	
	(k) - Cornell Next Signal	each	1			
	(I) - Veterans Next Signal	each	2			1
	(m) - Right Lane Must Turn Right	each	1			
	(n) - Begin Right Turn Lane - Yield to Bikes	each	1			
	(o) - NE Brookwood Pkwy street name sign	each	1			
	(p) - NE Veterans Dr street name sign	each	2			\$
				\coprod		İ
36	Furnish and Install All Pavement Striping and Markings			\coprod		
	per plan.	LS	1			

	LANDSCAPING AND RESTORATION					
•						
37	Furnish and install irrigation system complete	LS	1			
38	Furnish and install 12" of Top Soil in landscape strip					
	and center median per plans	CY	1362			=
39	Furnish and Install Street Trees					
	a) Village Green - Zelkova Serrata	each	54			
	b) Lavalle Hawthorne	each	4			
	c) Paperbark Maple	each	46			
	d) Tricolor Beech	each	33		-	-
40	Furnish and Install Landscaping Shrubs					
_	and Groundcover per plans					
	a) Abotswood Potentilla	each	40			
	b) Kinnikinnick	each	3491			
	c) Lowfast Cotoneaster	each	896			
	d) Creeping Broom	each	1383			
	e) Winter Creeper	each	211			
			1			namu-e
41	Additional Grading and Hydroseeding	LS	1			W. W.L. Worter.
42	Restoration of Landscaping and Other Items					
	Disturbed by Construction	LS	1	-		-
43	Extra Work	T&M			\$	50,000.00
	TOTAL			3		
					-	
	·					

ADDENDUM NO. 1

TO: All Bidders and Plan Holders

FROM: Charlie Shell, Principal Engineer

PROJECT: Construction of NE Veterans Drive – Phase II

No. 10444

DATE: January 25, 2013

This addendum to the contract documents is issued to clarify, correct, and supplement the drawings and contract documents issued as "Construction of NE Veterans Drive – Phase II", bid closing date January 31st, 2013.

Please be advised of the following revisions to the bid documents:

Changes to the Construction Plans:

Traffic Signal Plans

Sheets TS-1, TS-2, TS-4, TS-5, TS-8, TS-9, TS-10, of the traffic signal plans have been revised. The revised sheets issued with this addendum shall replace those sheets previously issued.

Illumination Plans

Sheets 1, 3, and 6 of the Illumination plans have been revised. The revised sheets issued with this addendum shall replace those sheets previously issued.

Clarifications:

- 1. Sheet C-103 contains a typo for the length of 10" C-900 pipe shown at station 51+14.75. The length of pipe should be 12 feet; not 184 feet. There is no change to the total quantity of 10" C-900 pipe shown in the Bid Proposal Form.
- 2. Sheet S-106, note 3, indicates that cold tape inlaid stripping shall be installed at the time of paving. All paving for Veterans Drive will be concrete with 3M 380 IES cold tape to be applied with SPA 60 glue after paving.
- 3. All pavement markings on sheet SS-4 apply to the asphalt on Brookwood Parkway and will be thermoplastic.
- 4. The existing 36" storm line is ADS N-12 west of station 53+28. The existing 36" storm line is reinforced concrete east of station 53+28.
- 5. The Area Drain to be installed at station 53+28 will be a ditch inlet as shown on sheet C-100D.
- 6. The drain rock in the sidewalk drain detail shown on C-100D will be ¾" to ¼" drain rock with no fines.
- 7. The existing storm line in Brookwood Parkway (Sta. 72+46) to be filled with grout is 12 inch in diameter.
- 8. The excavation quantity in the Bid Proposal Form includes all site strippings.

It is the responsibility of the prospective bidders to note the contents of this addendum and that the owner is made
aware that the addendum has been received. Acknowledge receipt by noting addendum number and date of
receipt on the signature page following the bid proposal form (Section X) and return with the bid packet on
January 31 st , 2013 at 2:00 p.m.

Bidder	Name:	 		
	Address:	 		
Acknowled	ged receipt by:			

CONTROLLERS

- Controller (See Signal Plan).
- Install model 2070 controller and control equipment in model 332 cabinet with riser frame, orient louvered door as shown
- Retain and protect existing controller and cabinet.

POLES

- Install (L=length) foot traffic signal mast arm.
- Install (L=length) foot luminaire arm.
- (PP) Install pedestrian signal pedestal with frangible base.
 - Install Type (T = Type) standard traffic signal mast arm pole with luminaire pole extension (35 ft. mounting height), as per Drg. No.'s 6910 and 9620. See sheets TS-6 and

SIGNS

- Install street name sign (N) on mast arm, use 12" 0.125mm flat blade aluminium blanks mounted to mast arm with stainless steel bands and hardware (diamond grade sheeting). See sign detail sheet SS-2.
- Install aluminum (30"x36", type "W7") left arrow "ONLY" sign (R3-5R)
- Install aluminum (30"x36", type "W7 Mod.") Right turn yield to peds on green ● " sign (OR22-14)
- Install aluminum (30"x36", type "W7") left arrow "ONLY" sian (R3-5R)
- Install crosswalk closure barricades with signs (both side (CW) of barricade). See TM490.

JUNCTION BOXES

- Remove existing junction box.
- Retain and protect existing junction box.
- Install 30"x17"x12" (min. dimension) precast concrete iunction box.
- Install 30"x17"x12" (min. dimension) precast concrete junction box with concrete apron.
- Install 30"x17"x12" (min. dimension) tandem precast concrete junction box. (See ODOT TM472)
- Install 36"x24"x24" (min. dimension) polymer concrete communications junction box. See sheet TS-8.
- Λ Junction box (See Interconnect Plan)

SIGNALS

- Ph
 - Install phase (Ph-phase) countdown pedestrian signal with

LEGEND C<u>ONTINUED</u>

WIRES

- Install (N=number) No. 14 AWG size wire type THWN wires
- Install (N=number) No. 12 type THWN (Pedestrian signal system N-12C common)
- N-C Install (N=number) No. 8 type THWN (Signal system common)
- Install (N=number) No. (G=AWG wire size) type XHHW wires
- N/G Install (N=number) No. (G=AWG wire size) type THWN wires
- **⊕**Ph Includes 3 spare wires for phase (Ph-phase) as per table
- Install (N=number) twisted pair PE-39 (gel filled) Interconnect Cable
- Install poly pull line

- Install base mounted service cabinet, 120/240 volt (BMCL) metered, for signal and signal pole mounted illumination systems.
- (TC)Install terminal cabinet.

CONDUITS

- Install (S=size) inch electrical conduit
- Electrical conduit (See Signal Plan)
- Install conduit and wire as required by power company
- Interconnect conduit (See Interconnect Plan)
- (cs)Install 2" conduit stub (For future use, cap ends)
- Retain and protect existing interconnect conduit
- Abandon existing interconnect conduit
- Retain and protect existing electrical conduit
- Install conduit by horizontal directional drilling. Open trench not allowed.

- (LED) Install LED luminaires at signal (Leotek GC2 street light).
- Install photocontrol electronic relay on pole, as per T.R.S. Drg. No. TM465.

<u>FIRE PREEMPTION</u>

- Install channel (Ch=channel) fire preemption detector feeder cable.
- Install channel (Ch-channel), (N-number) barrel fire preemption detector unit.

<u>VIDEO DETECTION</u>

- Install variable focal length video detection camera housing and sunshield number (N=number).
- Install video detection coaxial feeder and power cable (N=number).
- Video detection zone for phase (Ph = phase).

COMMUNICATIONS



Install Ruggedcom RS930L edge switch.



Install communications panel for twisted pair copper. See sheet IC-9.

SIGNAL MOUNTING OPTIONS

B = Adjustable signal bracket assembly w/rain cap(s) (Install 1 inch metallic chase nipple)

SIGNAL HEAD TYPES

2 = 12" R, 12" Y, 12" G

5 = 12" R, 12" Y, 12" G, 12" YRTA, 12" GRTA


6LX= 12" RLTA, 12"YLTA, 12" FYLTA/12" GLTA (BI-Modal Display)

VIDEO CAMERA MOUNTING OPTIONS

- MA = Mast arm mount
- LA = Lumingire arm mount
- AB = Adjustable Bracket
- MA = Mast Arm

GENERAL NOTES:

- 1. All materials and workmanship shall conform to Washington County ordinances and special provisions, the 2008 Oregon Standard Specifications for Construction, and the Oregon Standard Drawings listed below.
- 2. The CONTRACTOR shall supply all equipment, materials, and labor required for the signal operations shown on this plan. All signal control equipment shall be tested at the ODOT signal lab in Salem at the CONTRACTORS expense.
- 3. The CONTRACTOR shall verify the locations of existing utilities and coordinate this work with the utility companies/agencies to eliminate any conflicts.
- 4. The CONTRACTOR shall coordinate work with PGE for power service connection. The contractor shall install conduit and wiring to the power source as required by PGE. The CONTRACTOR shall coordinate with PGE (Service Desk, 503-736-5450) for all power requirements.
- 5. The ENGINEER shall field verify the location of all signal equipment before installation.
- 6. Washington County will provide signal field testing services at the CONTRACTORS expense.
- 7. Washington County will provide signal timing.

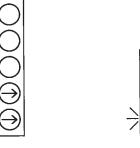


TYPE 5 SIGNAL HEAD

TYPE 6LX SIGNAL

ENGINEER 59948PE OREGON / VE 12. MIHONY S EXPIRES: 06/30/14 PROJECT NUMBER





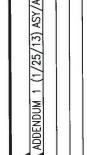

 $\triangleleft \triangleleft$ BY DATE DRWN AMT 01/13 DSGN ASY 01/13 CHKD CWR 01/13

VETERANS DR. -ROOKWOOD PKWY WASHINGTON COUNTY **PLANS**

SIGNAL

TRAFFIC

шiШ ZШ

ACCOMPANIED BY DWGS. TM450, TM457,


TM458, TM460, TM462, TM465, TM467, TM470, TM472, TM482, TM485, TM488


TM490 & SHEETS TS-2 Thru TS-10

SHEET NO. 1 OF 10 SHEET TITLE TS-1

Install phase (Ph=phase) vehicle signal

clamshell mount and pushbutton with 'H' mount.

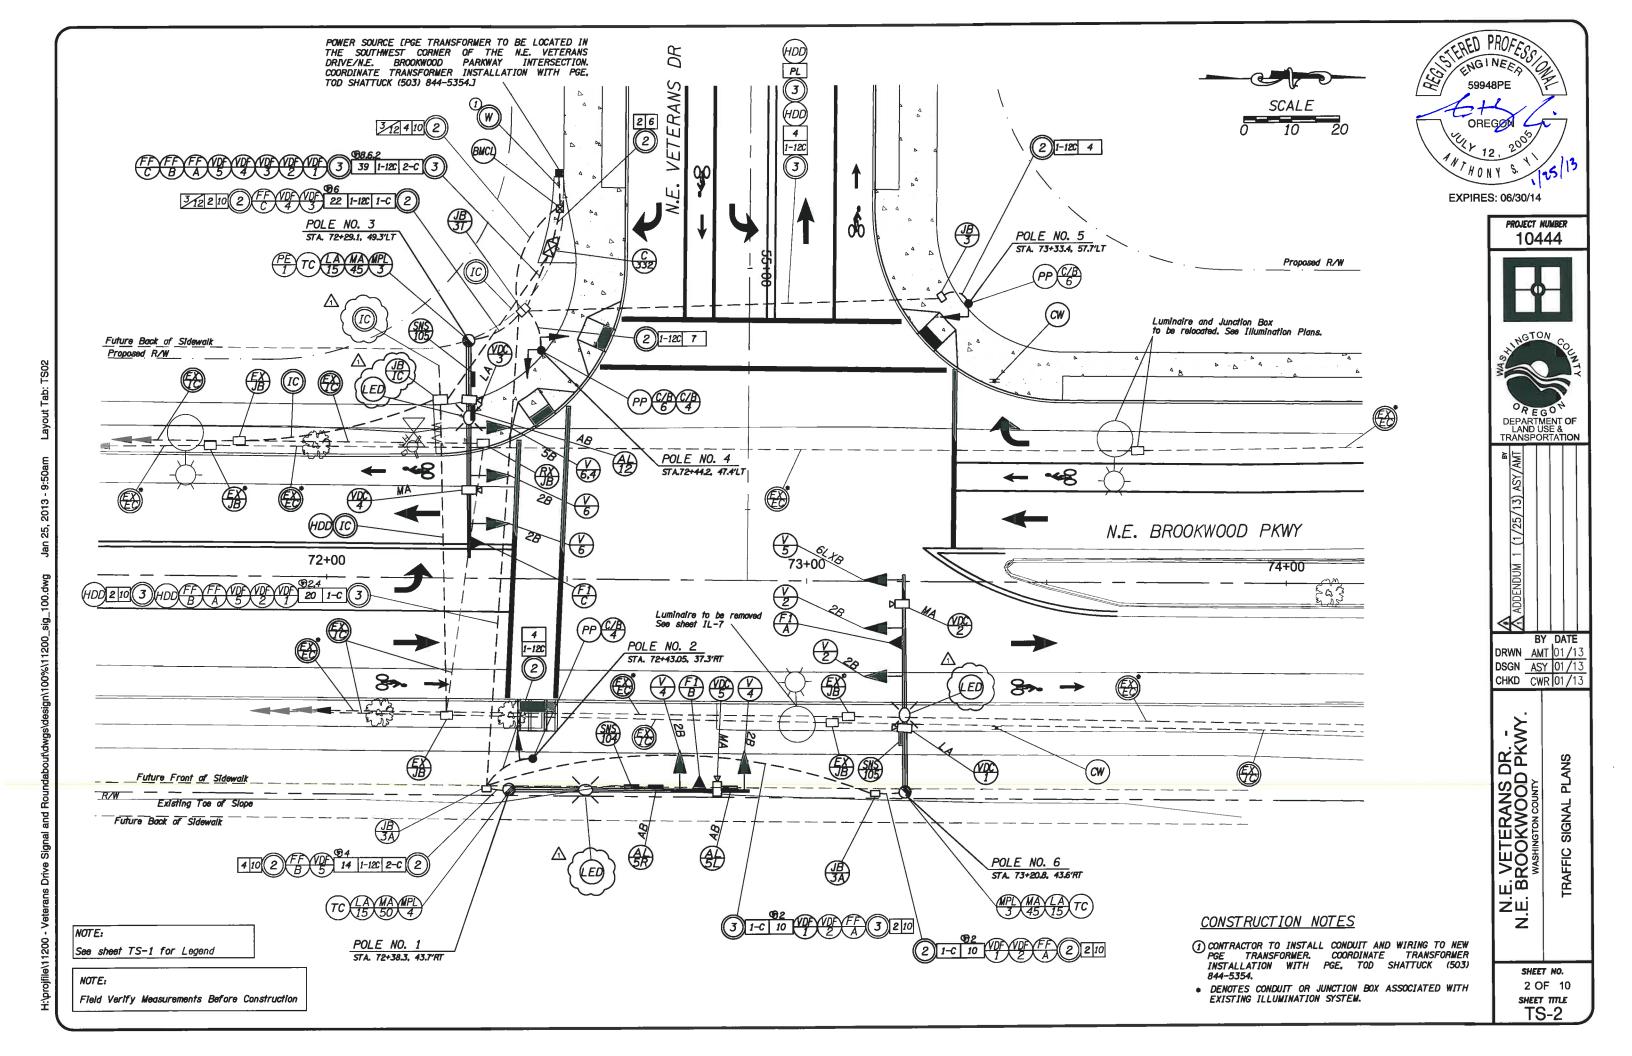

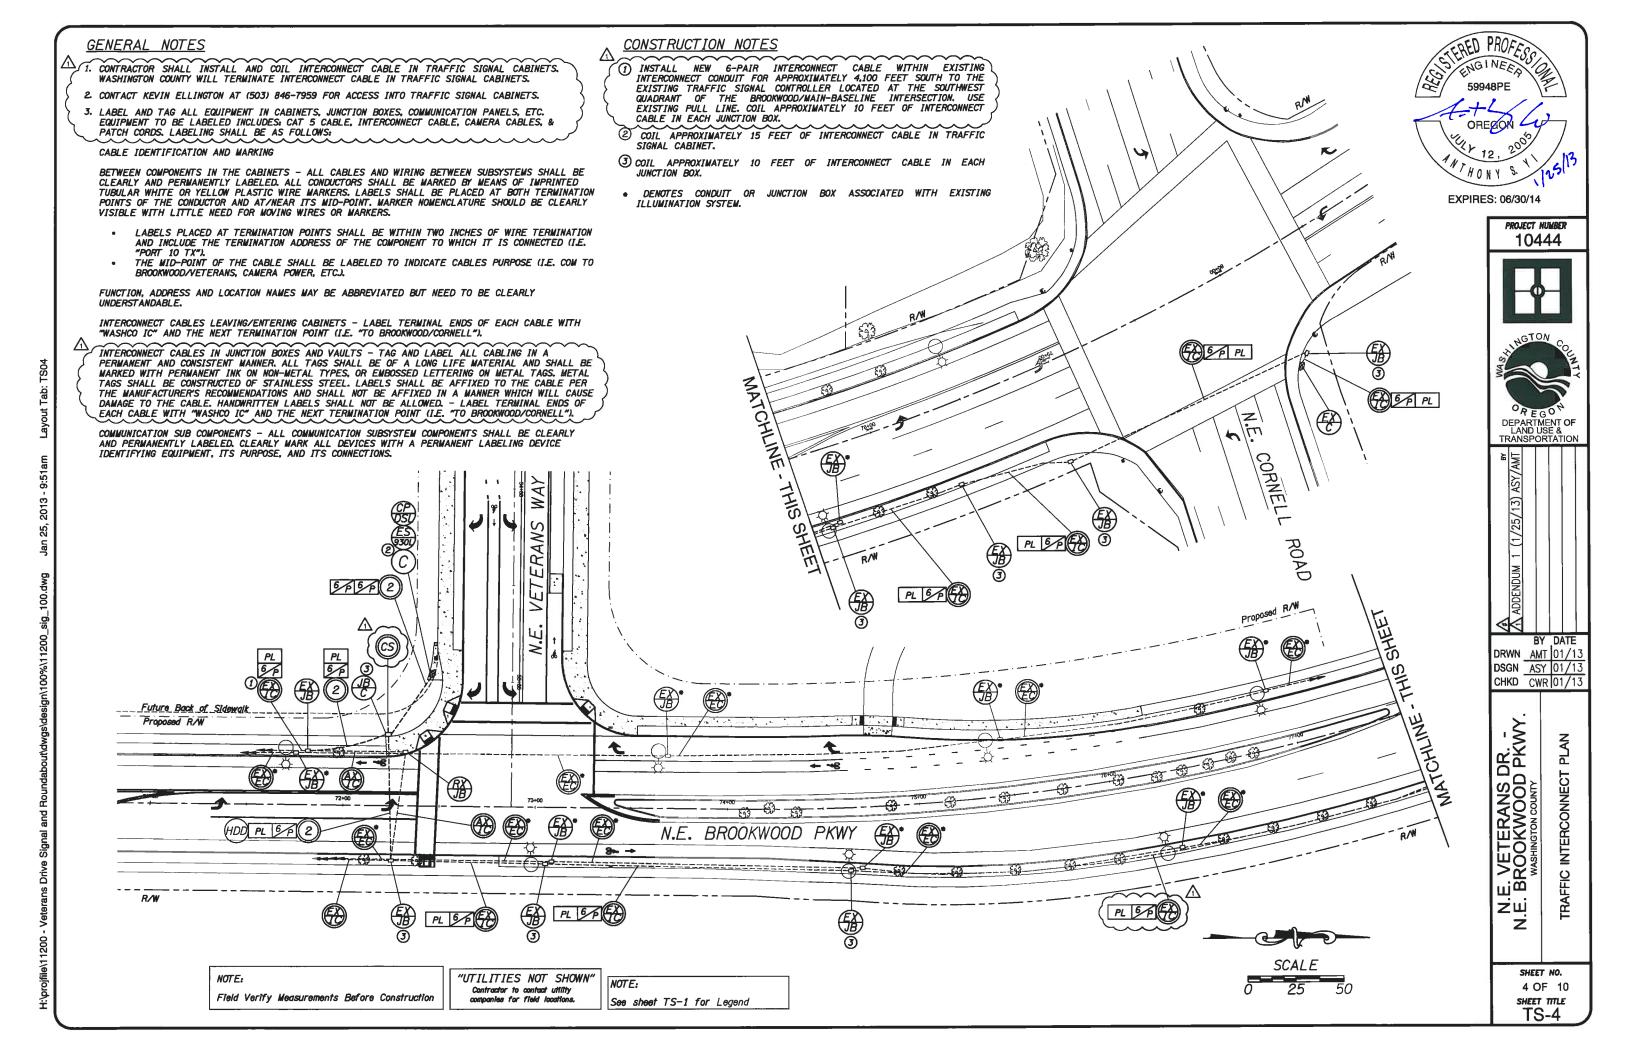


POLE ENTRANCE CHART

					EQUIP	MEN	T ON	I POL	E.E			EQUIPMENT ON MAST ARM (Length in Feet and Equipment Type)										UMI in Feet)	NAIRI	FIXTURE			FOUNDATION INFORMATION			
POLE NO.	DWG. NO.	TYPE	Strain Pole "Ah"	MAST ARM ORIENTATION (RELATIVE TO MORTH ARROW)	PED. SIGNAL DEG.	TERM. CABINET DEG.	SIGN DEG.	TRAFFIC SIGNAL DEG.	PHOTO CELL DEG.	FIRE PRE- EMPTION	ARM LENGTH	D1	D 2	D3	D4	D 5	D 6	D7	D 8	D9	D 10	ARM LENGTH	ARM DEG.	MOUNTIN HEIGHT	TYPE	TYPE	NO. OF LEDs	DRIVE CURRENT	STANDARD FOOTING TYPE	required Footing Depth
1	TS-2	MPL4	-	0	-	180	-		-	-	50.0	0.5 V2	4.0 SA	6.5 VDC	10.5 F	14.5 V2	19.0 SA	24.5 ST	-	-	-	15	0	35	LED	M-C-III	120E	700 mA	MPL4*	10.5'
2	TS-2	PP		-	180	-	-	-	-	-	-	-	-	-		1	-	-	-			-	<u>-</u> _	- }	-		-	-		-
3	TS-2	MPL3	-	90	-	180	-	-	180	-	45.0	3.0 F	7.0 V2	14.0 VDC	17.0 V2	27.0 V5	30.0 SA	37.0 ST		-		15	0	35	LED	M-C-III	120E	700 mA	MPL3*	10.5'
4	TS-2	PP	-	-	180,270	-	-	-	-	-	-	-	<u> </u>	<u> </u>	<u> </u>	<u> </u>	-	·	<u> </u>	-		-	1	- }	-	-	-	-	-	-
5	TS-2	PP	-	-	90	-	-	-	-	-	-	<u> </u>	-	-		-		<u>-</u>		<u> </u>	-	-	•	- }	-	-	-	-	-	-
6	TS-2	MPL3	-	270	-	180	•	-	-	-	45.0	1.0 V6LX	6.0 VDC	11.0 V2	14.0 F	21.0 V2	34.0 ST	<u> </u>	-	-	-	15	0	35 (LED			700 mA	MPL3*	10.5'

BRACKET MOUNT:

V2 = Traffic Signal Type 2, Adjustable Bracket Mount Tenon Not Required (See Std Dwg. TM460 & TM462) V5 = Traffic Signal Type 5, Adjustable Bracket Mount Tenon Not Required (See Std Dwg. TM460 & TM462)
V6LX = Traffic Signal Type 6LX, Adjustable Bracket Mount Tenon Not Required (See Std Dwg. TM460 & TM462) SA = Sign, 30" x 36" Aluminum w/Adjustable Bracket Mount Tenon Not Required (See Std Dwg. TM465) ST = Street Name Sign, Aluminum


F = Fire Preemption (See Std Dwg TM465) VDC = Video Detection Camera

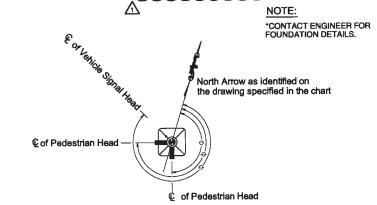

PEDESTRIAN PEDESTAL / VEHICLE PEDESTAL **ORIENTATION DIAGRAM**

NOTE

Equipment shown on the orientation diagram is a clarification of angles of equipment that may be located on a Pedestrian Pedestal or Vehicle Pedestal

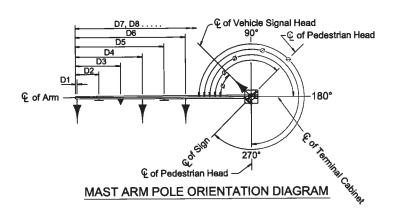

NOTE

Equipment shown on orientation diagram Is clarification of distance and angles of equipment that may be located on a Mast Arm or Signal Pole






E. VETERANS DR. -BROOKWOOD PKWY. DETAILS

TRAFFIC SIGNAL

ŻЩ ż

> SHEET NO. 5 OF 10 SHEET TITLE TS-5

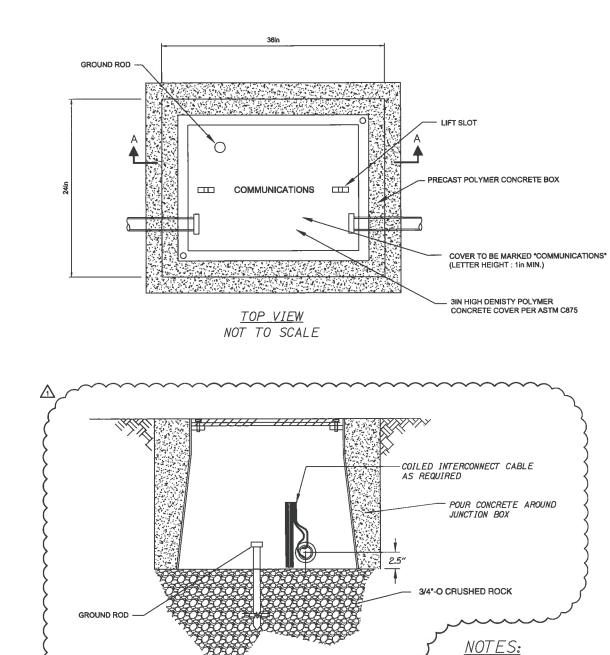

SIDE VIEW

TYPE C JUNCTION BOX


BELL END OR END PIECE (TYP.)

POUR CONCRETE AROUND JUNCTION BOX

12" (Min.)

SECTION A-A

TYPE C JUNCTION BOX

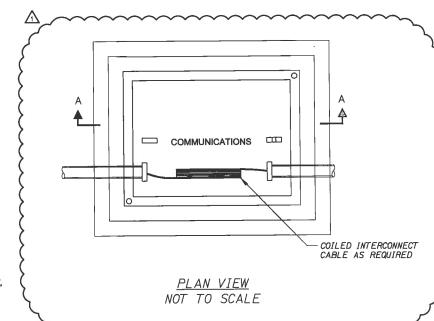

NOTES:

1. CONDUITS SHOWN ARE FOR EXAMPLE ONLY. ADDITIONAL CONDUITS MAY BE REQUIRED AS SHOWN ON THE PLAN SHEETS.

2. SEE STANDARD SPECIFICATIONS SECTION 960.42 REGARDING HOLD-DOWN BOLTS FOR TRAFFIC COVERS AND ADDITIONAL REQUIREMENTS.

3. CONDUITS SHALL EXTEND INTO THE JUNCTION BOX A NOMINAL 2in FROM THE INSIDE WALL.

4. FOR CONDUIT END TREATMENT REFER TO ODOT STANDARD SPECIFICATIONS FOR CONSTRUCTION, LATEST EDITION (SEE SECTION 960.42) AND OREGON STANDARD DRAWING LATEST EDITION (TM472).

5. AFTER REMOVING THE EXISTING JUNCTION BOXES, THE CONTRACTOR SHALL ADJUST THE OPENINGS TO FIT THE NEW COMMUNICATION BOXES.

6. ALL EXISTING CONDUIT ELBOWS WITHIN THE EXISTING JUNCTION BOXES SHALL REMAIN INTACT EXCEPT THE INTERCONNECT CONDUIT. THE INTERCONNECT CONDUITS SHALL BE SPLICED AND EXTENDED THROUGH THE SIDES OF THE NEW COMMUNICATION BOXES.

7. IN JUNCTION BOXES WHERE THERE ARE EXISTING WIRES AND CONDUITS, THE CONTRACTOR SHALL ADJUST THEM AS NECESSARY TO MAINTAIN THE SYSTEM WHEN WORK IS COMPLETE.

8. THE CONTRACTOR SHALL FILL MATERIALS (SOIL OR CONCRETE) SURROUNDING THE NEW COMMUNICATION JUNCTION BOX TO SATISFACTION OF THE ENGINEER.

59948PE

OREGON

12, 2005

N/HONY \$ 12, 13

PROJECT NUMBER 10444

OF FEGON
DEPARTMENT O
LAND USE &

DEPARTMENT O LAND USE & TRANSPORTATIO


BY DATE
DRWN AMT 01/13


DRWN AMT 01/13 DSGN ASY 01/13 CHKD CWR 01/13

.E. VETERANS DR. . BROOKWOOD PKWY.
. WASHINGTON COUNTY
INTERCONNECT DETAILS

ZЩ

SHEET NO. 8 OF 10 SHEET TITLE TS-8

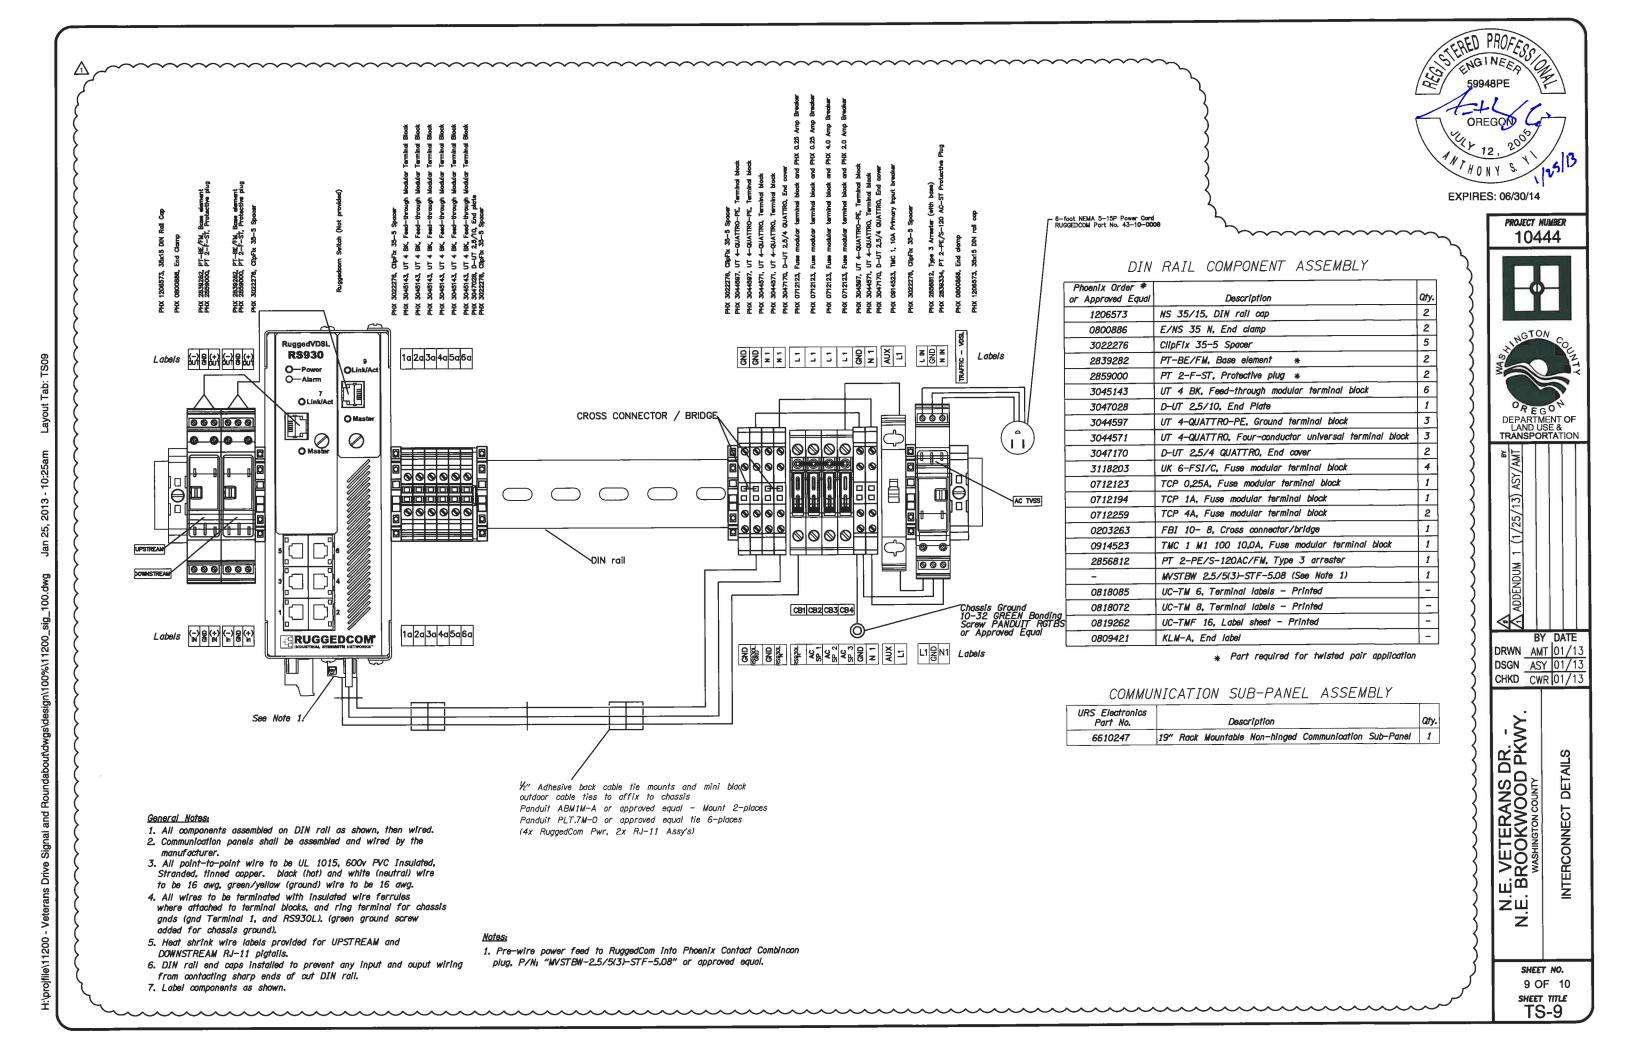

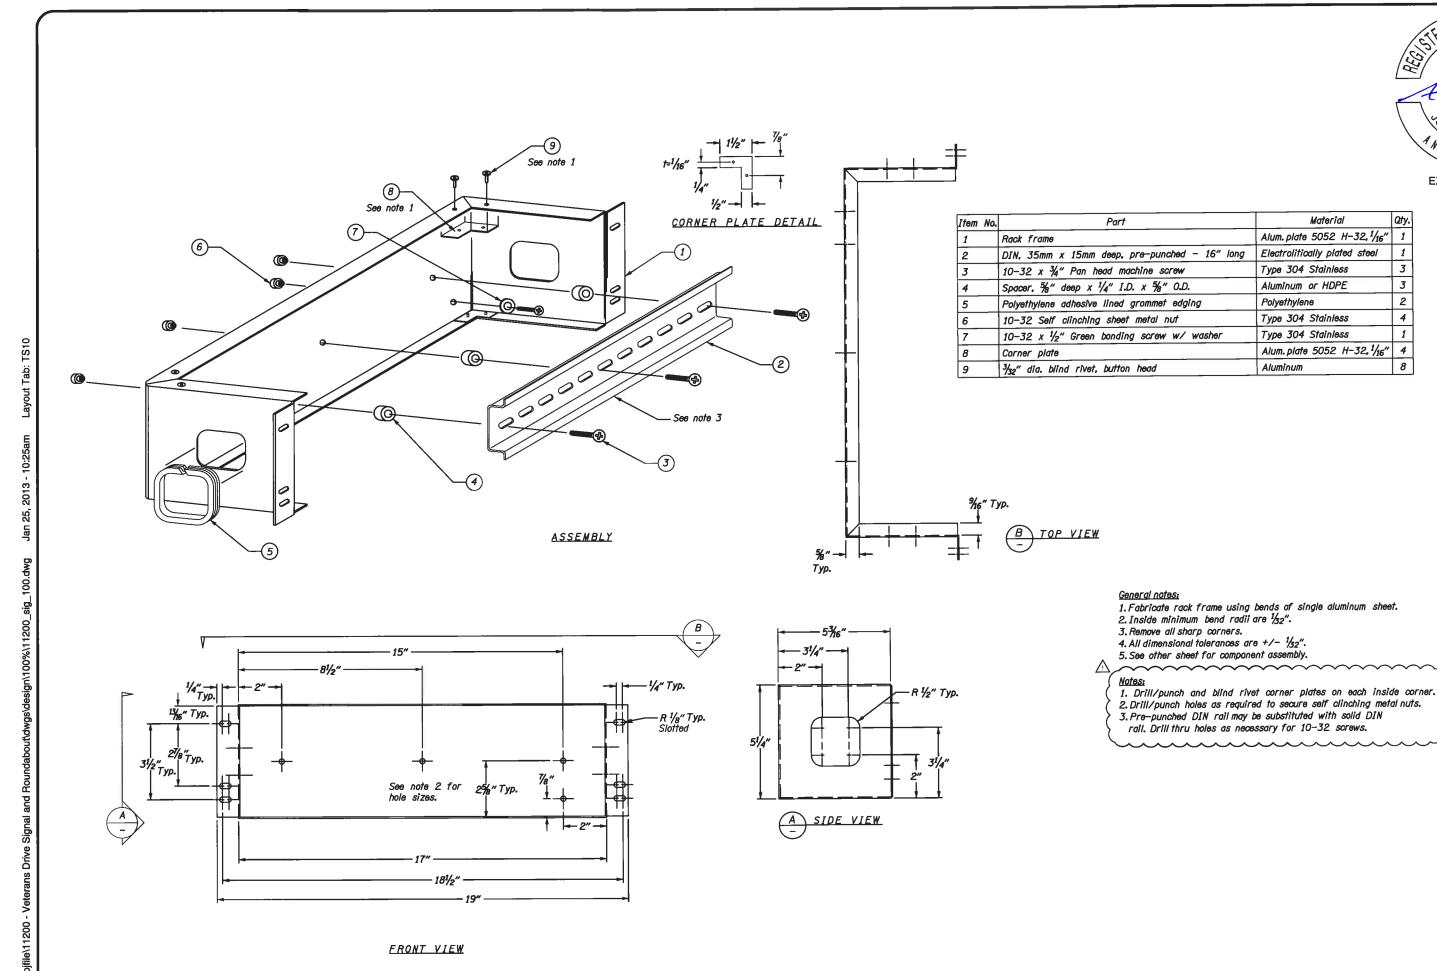

WIHONY S. EXPIRES: 06/30/14

3

2

4

1

8

PROJECT HUMBER 10444





DEPARTMENT OF LAND USE & TRANSPORTATION

DRWN _AMT 01/13 DSGN ASY 01/13 CHKD CWR 01/13

E. VETERANS DR. -BROOKWOOD PKWY. INTERCONNECT DETAILS ZШ

> SHEET NO. 10 OF 10 SHEET TITLE TS-10

LEGEND

CABINETS

Install base mounted service cabinet, 120/240 volt metered, for illumination systems per TM485 with circuits layout as shown on sheet 8.

POLES

Install Decorative Acorn light pole no. (N) for roadway illumination at (X) location

NW = Northwest of Service Cabinet

SW = Southwest of Service Cabinet

NE = Northeast of Service Cabinet SE = Southeast of Service Cabinet

JUNCTION BOXES

Install 17"x10"x12" (min. dimension) precast concrete junction box. See sheet 8.

Install 22"x12"x12" (min. dimension) precast concrete junction box. See sheet 8.

Install 30"x17"x12" (min. dimension) precast concrete junction box. See sheet 8.

Install 13"x24"x18" (min. dimension) PGE-approved precast concrete junction box.

Existing precast concrete junction box.

Remove existing precast concrete junction box.

CONDUITS

Abandon existing electrical conduit.

Retain and protect existing conduit

Remove existing electrical conduit

Retain and protect existing wiring

Install (S=size) inch electrical conduit

Install conduit and wire as required by PGE

GX

Install copper electrical XHHW conductors (N= Number of conductors, S= Size of conductors) with (X) AWG ground wire.

Install poly pull line (225 ft./lb. min. strength)

Install (N)-number #10 AWG 3-conductor cable. See lighting note No. 7.

PL/PGE Install poly pull line (500 ft./lb. min. strength)

(PGE)

Contractor shall coordinate with PGE to remove lighting cables from existing conduit, disconnect and reconnect to continue power to new pole locations.

LUMINAIRES

Install photocontrol electronic relay.

Retain and protect existing illumination pole.

Remove and relocate existing illumination pole.

Reinstall existing illumination pole.

LIGHTING NOTES:

1. Light poles shall be cast aluminum.

DECORATIVE STYLE MANUFACTURER: HADCO

CATALOG NUMBER: CP0520A

2. Anchor pole footing shall be approved pre-concrete. The approved footing is:

MANUFACTURER: **UTILITY VAULT COMPANY**

CATALOG NUMBER: 20R-LB-4-PGE

3. Junction boxes shall be approved splice boxes. Approved boxes are:

MANUFACTURER:

CATALOG NUMBER: H1324-18-3RYE20J00

CARSON INDUSTRIES SYNERTECH (UTILITY VAULT) NEWBASIS (ASSOCIATED PLÁSTICS)

SYN1324T011 (LID) + FL30TBOX18 (BOX) PCA132418A232

STRONGWELL (QUAZITE) CDR (ELECTRIMOLD) **ARMÒRCAST** HIGHLINE

PG-1324-Z501-17 PA-10-1324-18 A6001946APCX18 PHA1324 H18SE1

"Street Lighting" shall be in the lid marking area.

4. Luminaire shall be approved 200 watt ballast, M-S-IV lighting pattern with no individual photoelectrical control.

DECORATIVE STYLE MANUFACTURER: HADCO

CATALOG NUMBER: C0520G

5. The lamp shall be approved 200 watt high pressure sodium:

MANUFACTURER:

CATALOG NUMBER:

GENERAL ELECTRIC SYLVANIA

LU200 LU200

PHILLIPS LIGHTING

C200S66/ALTO

6. The Photoelectric Control shall be approved Twistlock, Fail-On, Electronic, 105-300 VAC, 60 HZ, per ANSI 136.10, Bronze Housing, 1.5 Lumen turn-on, Rated 1000 W Tungsten (1800 VA Ballast), 1.5:1 Turn-off/turn-on ratio, Solid Brass Plug Blades, Conformally Coated CDS Cell, 160 Joule MOV or expulsion arrester, 2-4 sec Turn-off delay. The approved photoelectric

MANUFACTURER: SOUTH CONN

CATALOG NUMBER: 6390BRZ-PGE

ACUITY BANDS (DTL) TYCO (ALR) TORK

POLE

HEIGHT

16 FT.

D124-1.5-1704 6290NPS-BR 5217-BR

SUN-TECH FISHER PIERCE

POLE

DECORATIVE STYLE

S124-1.5-STM-BR FP7673C-MCBE

7. #10 AWG, 600 Volt, 3-Conductor, Class B Stranding, Type TC, with Sunlight-Resistant 45-mil PVC Jacket. Suitable for direct burial installations. Insulation to be black, red, and green per NEMA WC-7 for NEC applications (TFN, THWN, THHN), with fillers or binding tape added to produce round outer jacket, rated 90 degree C dry and 75 degree C wet, 1000 ft NR reels. Jacket to display sequential footage markings. 2 reel labels, one attached to the outside flange surface, one attached to the drum wrapping; each to detail total footage, inside or starting footage.

LUMINAIRE

LENS

TALL ALUMINUM

ROOF ACORN

DISTRIBUTION

M-S-IV

GENERAL NOTES

1. All material and workmanship shall be in accordance with Washington County/City of Hillsboro standard specifications and Details except as modified in the contract documents and plans.

ILLUMINATION LEGEND

NE VETERANS DRIVE

- 2. All electrical equipment shall conform to the current standards of the National Electrical Manufacturers Association (NEMA) and the Underwriters Laboratories, inc. (U.L.) wherever applicable. In addition to the requirements of the plans, standard specifications, and the special provisions, all materials and workmanship shall conform to the current requirements of the National Electrical Code (NEC) the National Electrical Safety Code, standards of the American National Standards Institute (ANSI), and any local ordinances which may apply.
- 3. The CONTRACTOR shall verify location of all existing utilities prior to any construction. The plan location of utilities shown are approximate based on available records and field observations. Neither the OWNER nor the ENGINEER can guarantee the accuracy or completeness of utilities shown.
- 4. The CONTRACTOR will determine the exact location and elevation of all existing utilities which pertain to and affect the construction of the project. Field adjustments for the placement of conduit, pull boxes, pole and cabinet foundations shall be used to avoid conflicts with existing underground and overhead utilities.
- 5. The CONTRACTOR shall coordinate work with Tod Shattuck of P.G.E. at (503) 844-5361 to determine power source for the lighting system.
- 6. The CONTRACTOR shall install in-line fuse holder at bottom of each light pole in accordance to section 2920.26.
- 7. Install bushings on all conduit ends, in junction boxes, and in street light poles.
- 8. Grout the base of each pole and install a weep hole.

WASHINGTON COUNTY GENERAL NOTES

- 1. All materials and workmanship associated with illumination along Brookwood Parkway shall conform to P.G.E. Option "B" specifications. All materials and installation shall be approved by P.G.E.
- 2. Location of traffic signal illumination conduits and junction boxes are approximate. CONTRACTOR shall coordinate with other utilities to ensure proper installation.
- 3. The CONTRACTOR shall coordinate work with Tod Shattuck of P.G.E. at (503) 844-5354 to determine power source for the traffic signal system and signal lighting system.



INITIAL

LUMENS

22,000

LAMP

HPS

NOMINAL

WATTS

200

4. CONTRACTOR shall ensure existing street lights along Brookwood Parkway remain operational during construction.

> ACCOMPANIED BY ODOT STANDARD DWGS. TM465, TM485

NE VETERANS LLUMINATION L

 ∞

DRIVE EGEND

